



Plot Plan
 Scale: 1"=40'
 Lot Area: 6.22 ± acres

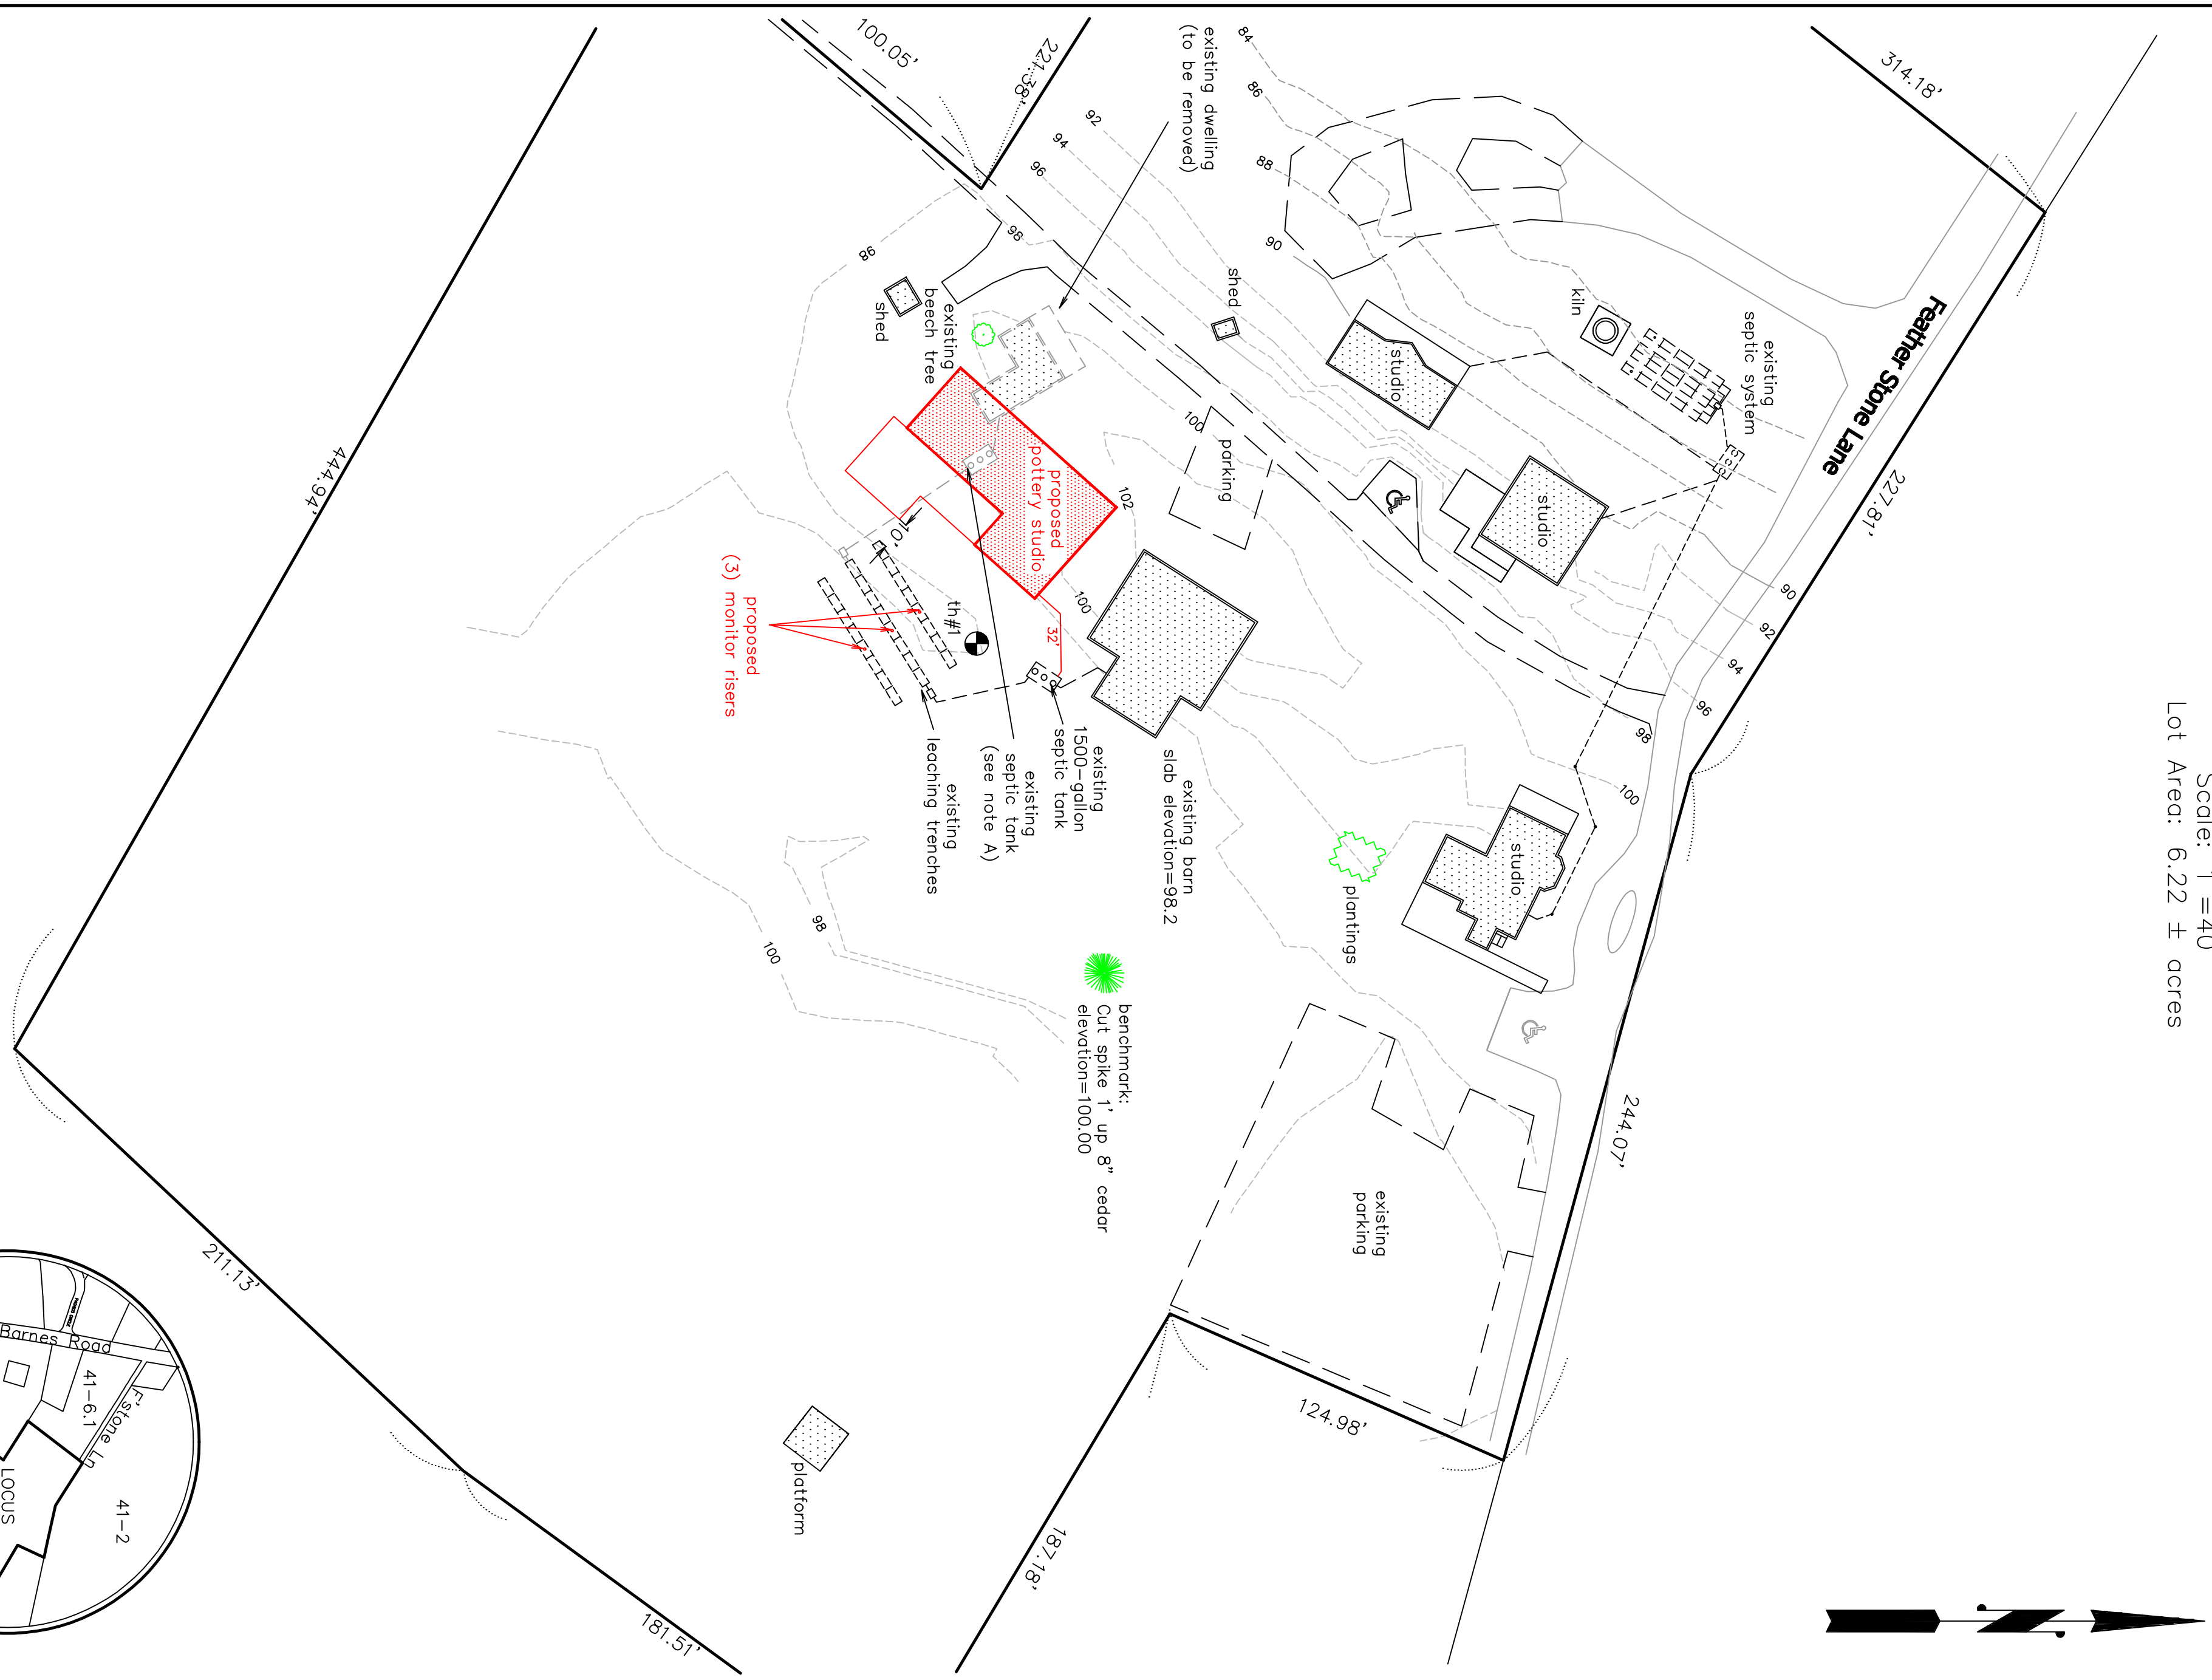

Notes:
 A. Existing septic tank and one D-Box to be abandoned, pumped and removed.
 B. Underground utilities to be located at start of construction.
 C. Invert at D-Box inlet to be verified at start of construction and relocated as required.
 D. See original system design by SB&H, Inc. August 26, 1997.


Profile of System

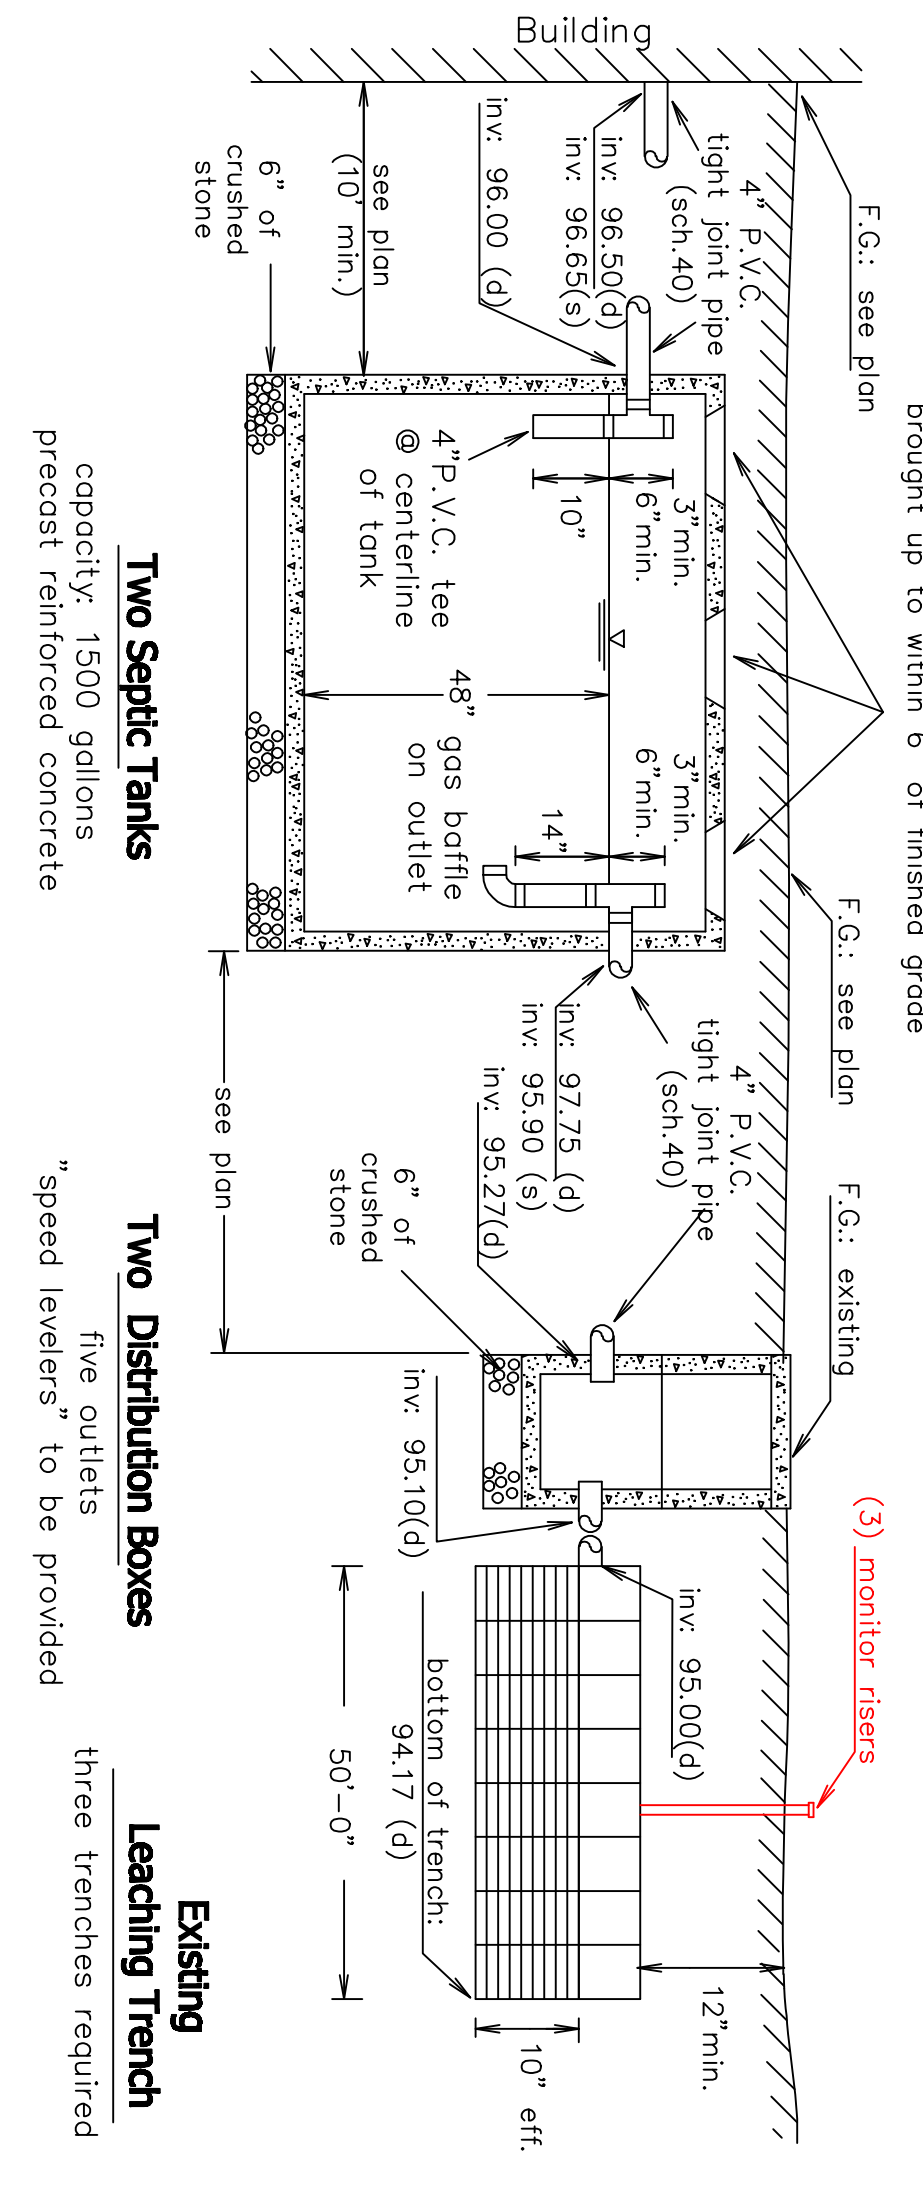

General Notes

- Elevations refer to approximate mean sea level datum. See bench mark on cut spike located 1' up 8" cedar (elev. 100.00)
- Finished grading to be done in accordance with plot plan.
- Percolation tests to be performed in accordance with the instructions of Title V of the Massachusetts State Environmental Code.
- All construction to conform to Title V and Board of Health requirements.
- All topsoil, subsoil and deleterious material, if any, must be excavated and removed below the leaching field and to a distance of 6/0 feet from all sides of the leaching field. Excavate down to 6/0 inches below the surface of the natural permeable soil. Backfill as required with materials meeting the requirements of section 15.255(3) of Title V. Construct trenches in this material.
- Septic tank and distribution box shall be watertight after construction, including covers.
- No driveway, parking or turning area or other impervious areas shall be located above the soil absorption system.
- No permanent structure may be constructed over the 100% expansion area.
- Schofield, Borhini & Hoehn Inc. will not be responsible for the performance of the system unless constructed as shown. Any alterations must be approved in writing by Schofield, Borhini & Hoehn Inc.
- The Board of Health shall require inspection of all construction by the design engineer and by the agent of the Board of Health.
- The design engineer and the system installer shall certify in writing to the approving authority that the system has been constructed in compliance with the approved plans.
- For best performance, the septic tank should be inspected at least once a year and when the total depth of scum and solids exceed 1/3 the liquid depth of the tank, the tank should be pumped.
- Distribution box cover to be brought to finish grade.

Plan View of System

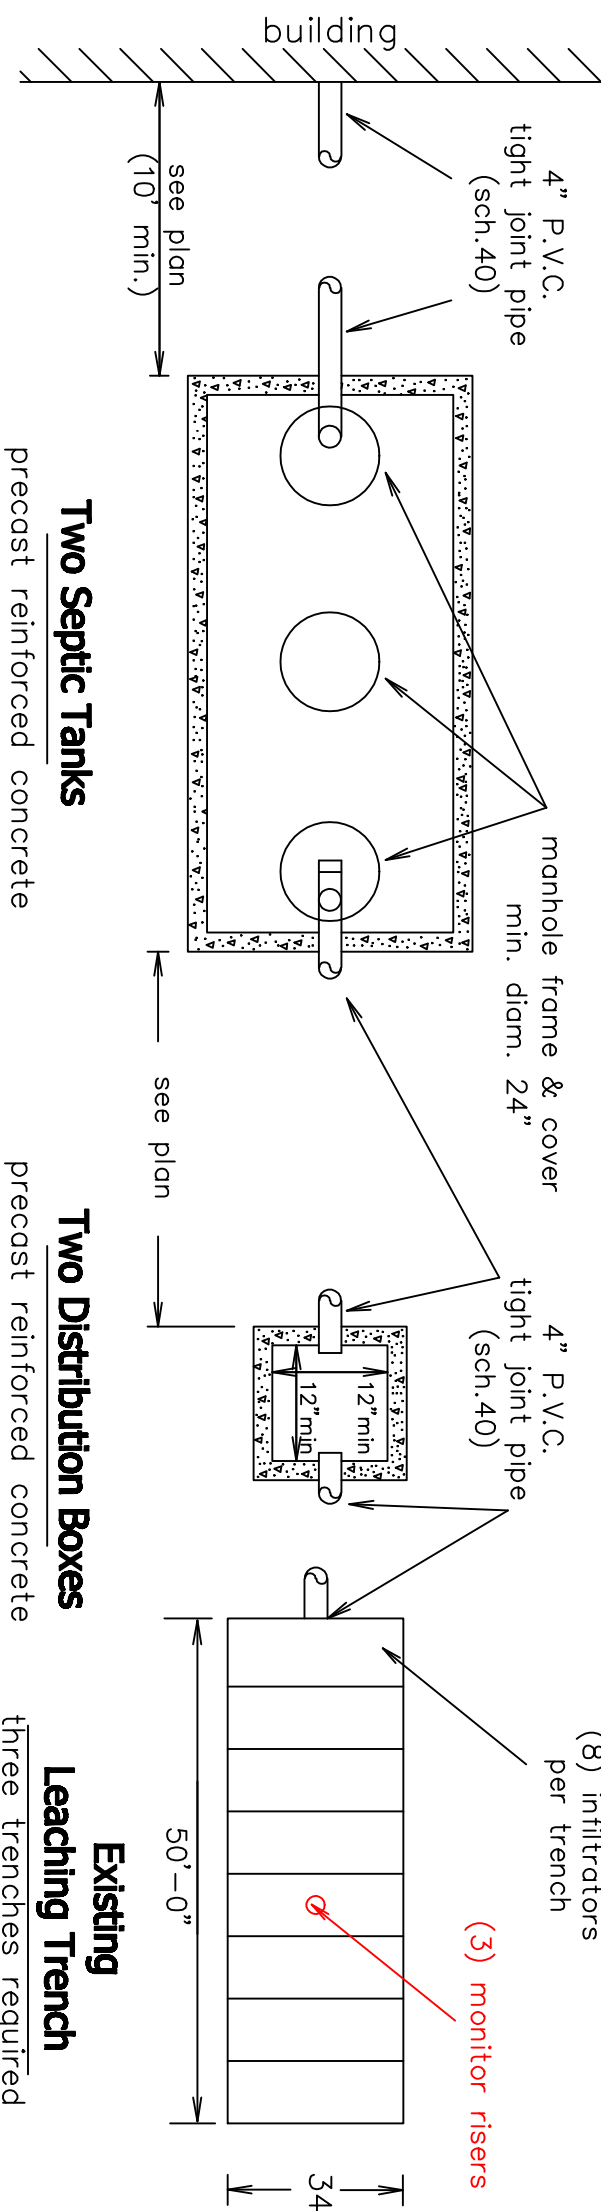

Design Data

- Estimated Hydraulic Loadings:
 Barn: 2100 s.f. at 50 gpd/1000 s.f. = 105 gpd
 Studio: 39 students @ 10 gallons per student per day = 390 gpd
 total: 495 gpd
 Garbage disposal is not allowed with this design.
- Septic Tank Size:
 Required capacity: 105 GPD x 200% = 210 gallons (min.) (BARN)
 Required capacity: 390 GPD x 200% = 780 gallons (min.) (STUDIO)
 Septic tanks provided: Two @ 1500 gallons each
- Design percolation rate: 5 M.P.I.
 Soil textural class: I
 Loading rate: 0.74 GPD/S.F.
- Leaching Area:
 Total leaching area provided: 675 S.F.
- Maximum Allowable Loading:
 675 S.F. x 0.74 GPD/S.F. x 1.67 = 834 GPD
 Actual hydraulic loading: 495 GPD

Legend

- XX---
- F.G. = XXXX Denotes proposed contour
- XX Denotes proposed finished grade
- XX Denotes existing contour
- Denotes test hole location
- P.V.C. Denotes polyvinyl chloride pipe, Sch. 40, unless noted
- EH.C.I. Denotes extra heavy cast iron
- W Denotes water service
- R Denotes approximate property line
- O.W. Denotes overhead wires
- D Denotes storm drain pipe

Proposed Sewage Disposal System

To Serve an Existing Barn and a Proposed 39 Student Pottery Studio and a Proposed 30 Featherstone Way-Assessor Parcel 41-6 Oak Bluffs, Massachusetts

Applicant: Featherstone Center for the Arts
 c/o Schofield, Borhini & Hoehn, Inc.
 PO Box 339
 Vineyard Haven, MA 02568
 Phone: (508) 693-2781

date: February 3, 2015 revisions:
 designed by: CPA drawn by: TED checked by: RJB
 Lond Surveying Civil Engineering
 12 Surveyor's Lane, Box 339
 Vineyard Haven, Mass. 02568
 508-693-2781
 www.sbhinc.net
 MV 5828

Schedule of Elevations


Location	Existing	Proposed
Top of Foundation	98.2/see arch	Finished Grade Above Structure
Basement floor	slab/see arch	
Invert of pipe at foundation	96.50(d)/96.65	see plan
Invert of septic tank inlet	96.00(d)	
Invert of septic tank outlet	95.75(d)	see plan
Invert of distribution inlet	95.27(d)	
Invert of distribution outlet	95.10(d)	existing
Invert of infiltrator inlet	95.00(d)	
Elevation of trench bottom	94.17(d)	

Deep Test Pit 1 (Surface Elevation: 99.6)

Depth	Horiz.	Soil Description	Date	Depth	Horiz.	Soil Description	test pit #	date	top of 12" of water depth from top of pit	elevation	rate (mp)
0"-8"	A	Sandy LOAM	July 29, 1997				1	7/29/97	48"	95.6	<5
8"-26"	B	Silt LOAM									
26"-114"	C	SAND & GRAVEL									

Percolation Test Data

test pit #	date	top of 12" of water depth from top of pit	elevation	rate (mp)
1	7/29/97	48"	95.6	<5

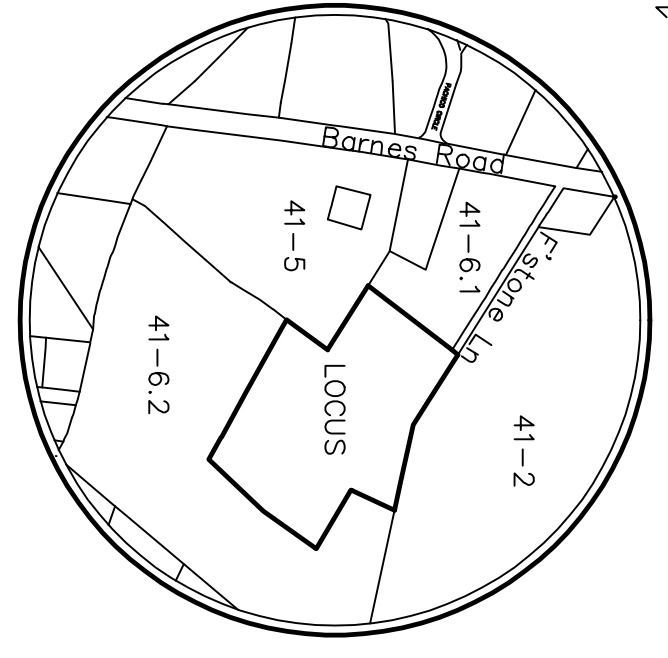

Locust Map No Scale