

All areas shown in red are post-1930 remodeling.



2 EXISTING WEST ELEVATIONS
SCALE: 1/4" = 1'-0"



1 EXISTING EAST ELEVATIONS
SCALE: 1/4" = 1'-0"

BRISTOL RESIDENCE
MARTHAS VINEYARD, MA

Job no: 2102
Revision:


Phase: EXISTING CONDITIONS
Description:
EXISTING NORTH ELEVATION

Date Issued: XX.XX.2021
Scale: AS NOTED

© 2021 - PAUL WEBER ARCHITECT, LLC

EX200

All areas shown in red are post-1930 remodeling.

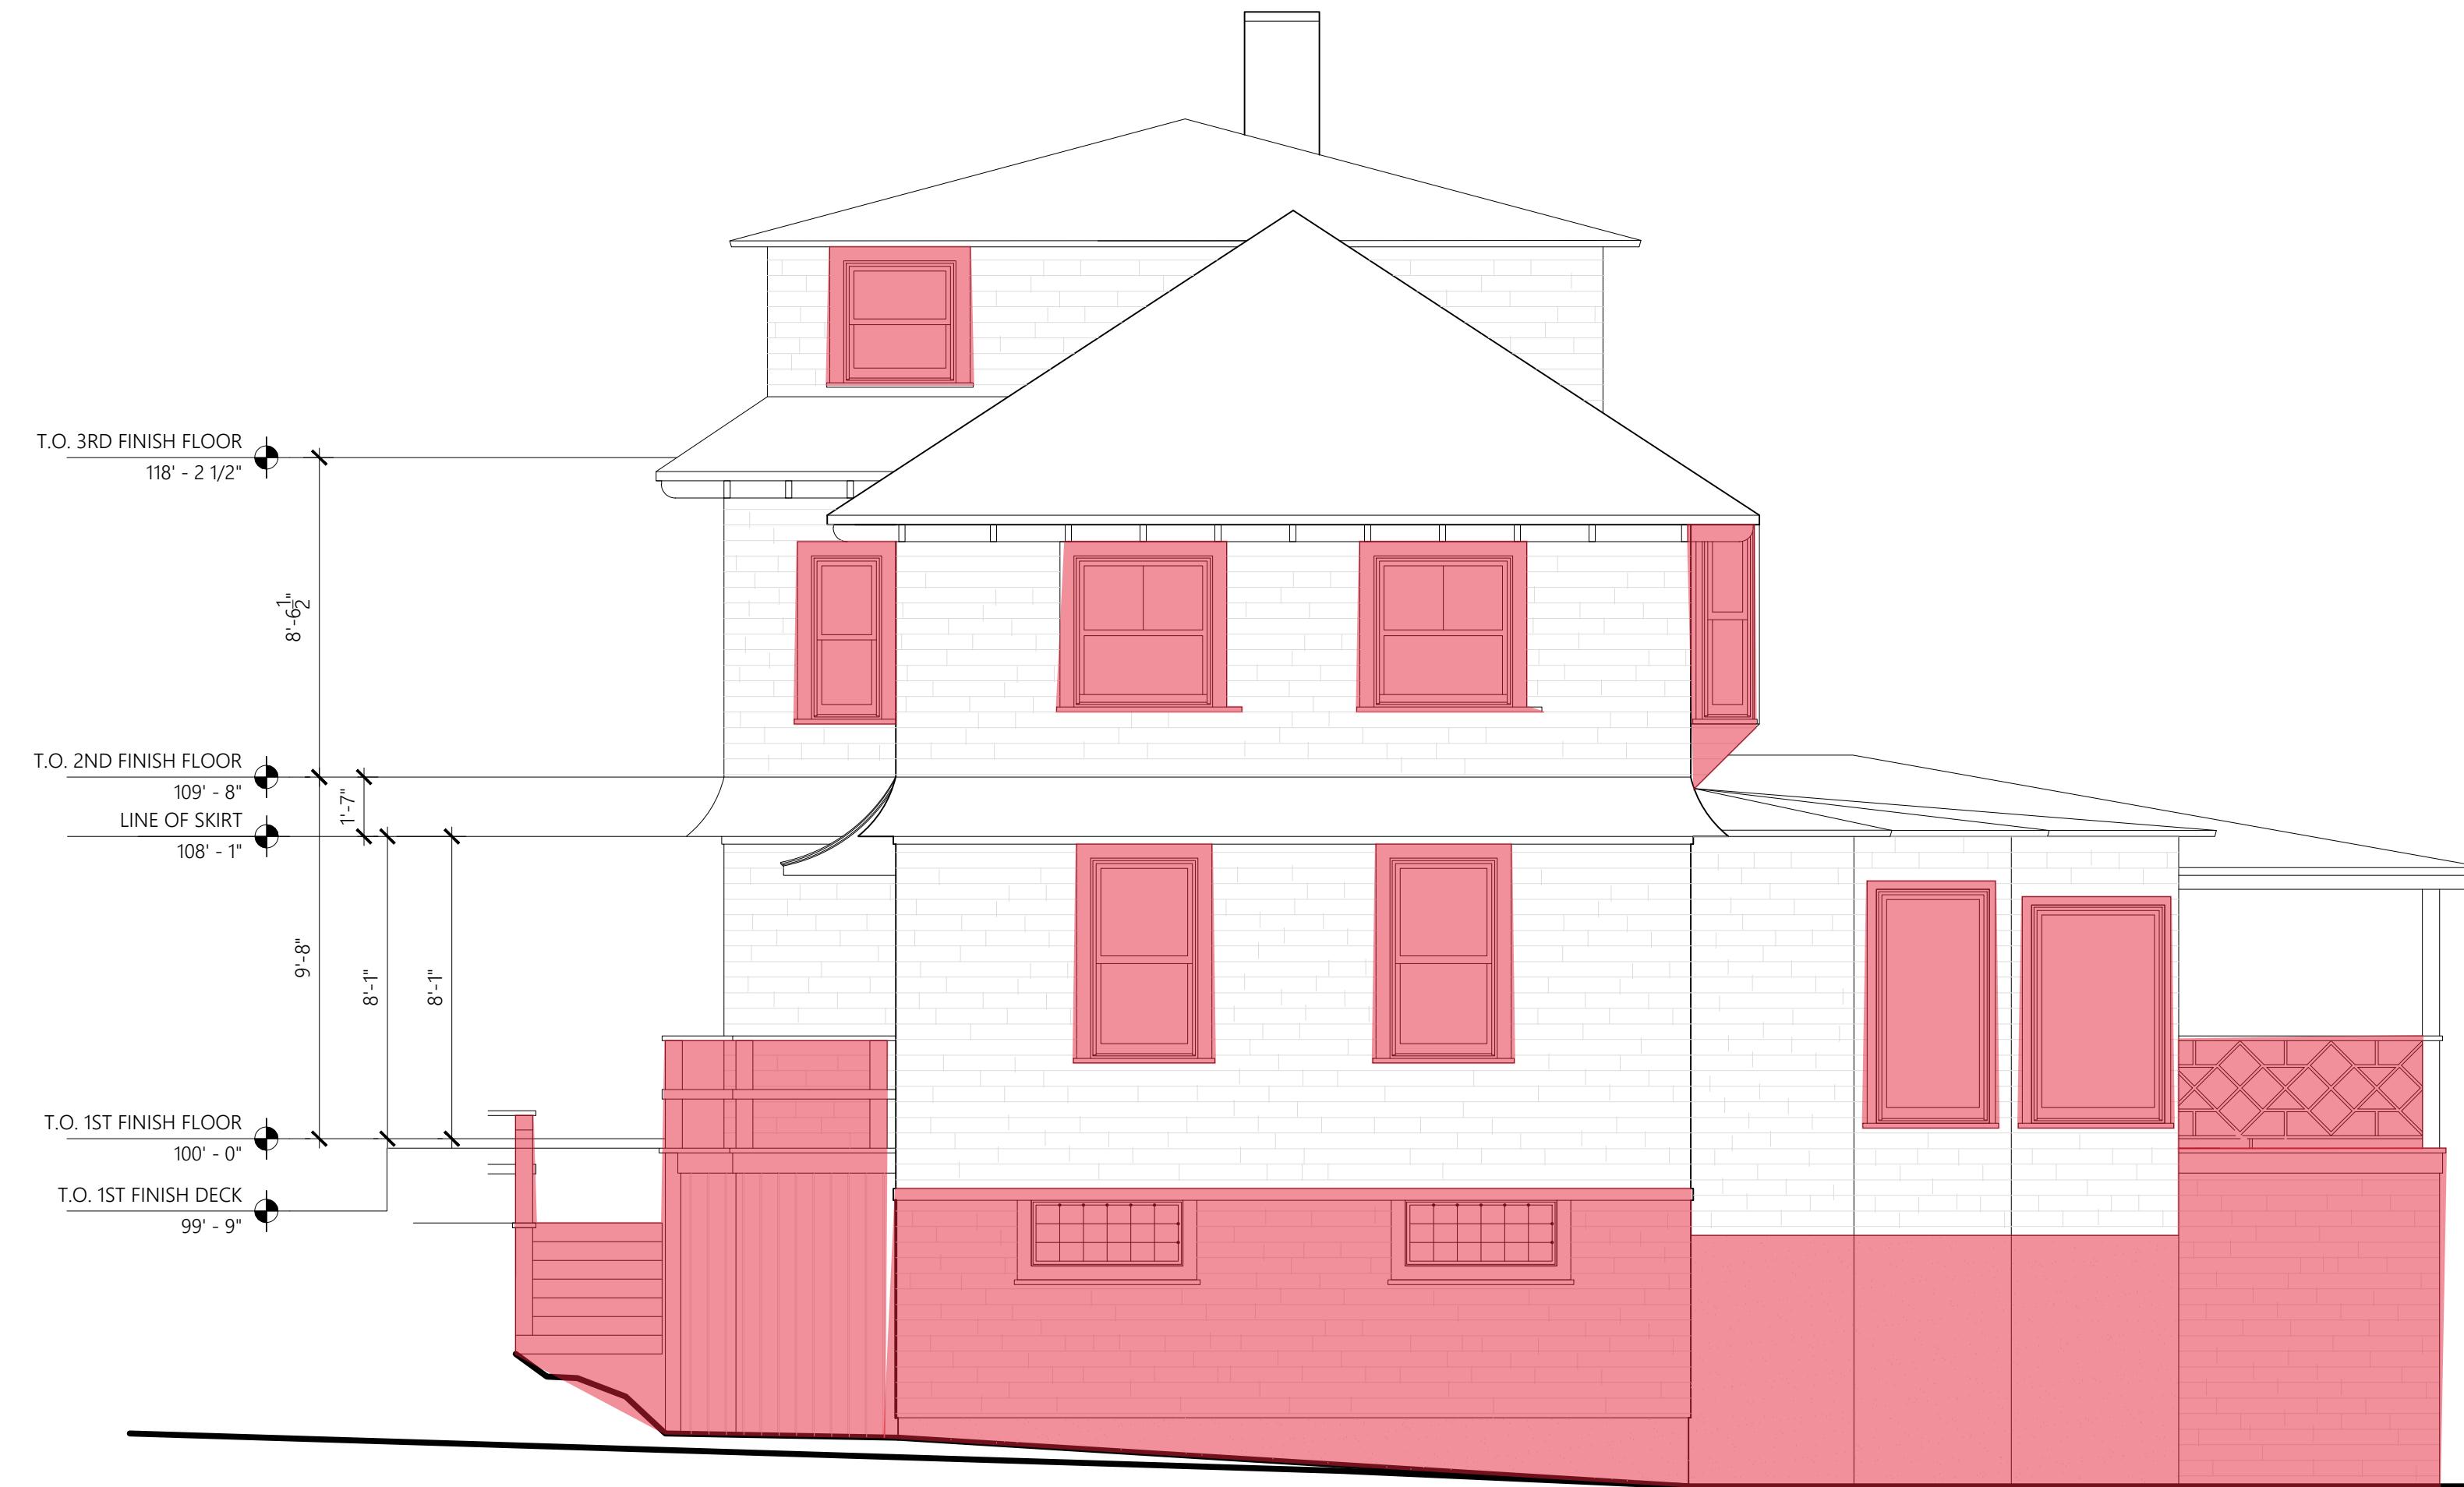

2 EXISTING NORTH ELEVATIONS
SCALE: 1/4" = 1'-0"



1 EXISTING SOUTH ELEVATIONS
SCALE: 1/4" = 1'-0"

BRISTOL RESIDENCE
MARTHAS VINEYARD, MA

Job no: 2102

Revision:

Phase: EXISTING CONDITIONS

Description:

EXISTING NORTH ELEVATION

Date Issued: XX.XX.2021

Scale: AS NOTED

© 2021 - PAUL WEBER ARCHITECT, LLC

EX201