



x 31.5 .....denotes as-built elevation

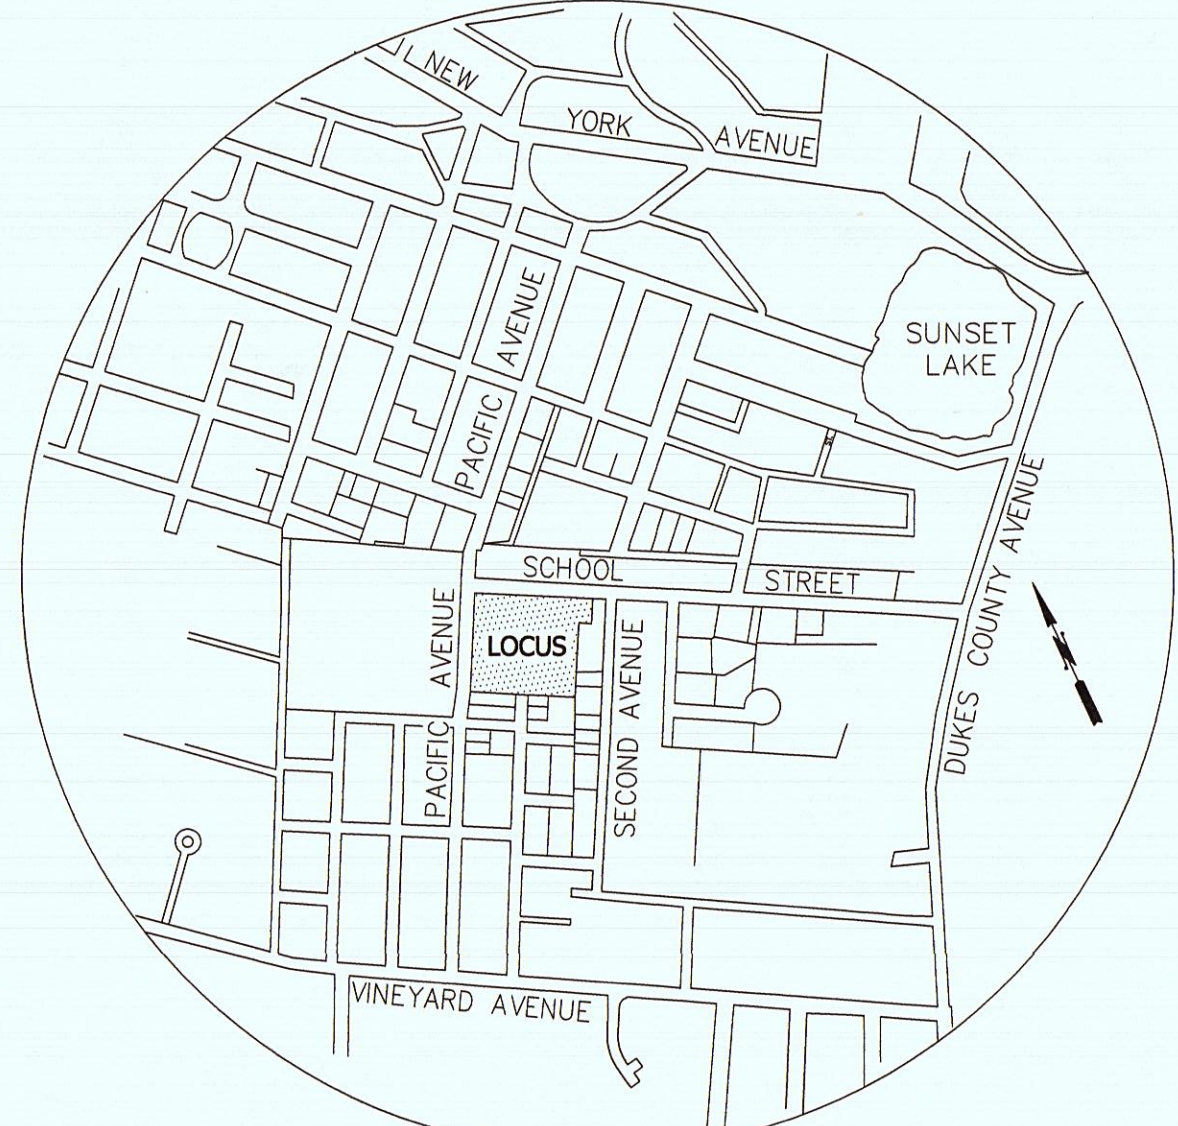

locus map - no scale

Oak Grove Cemetery

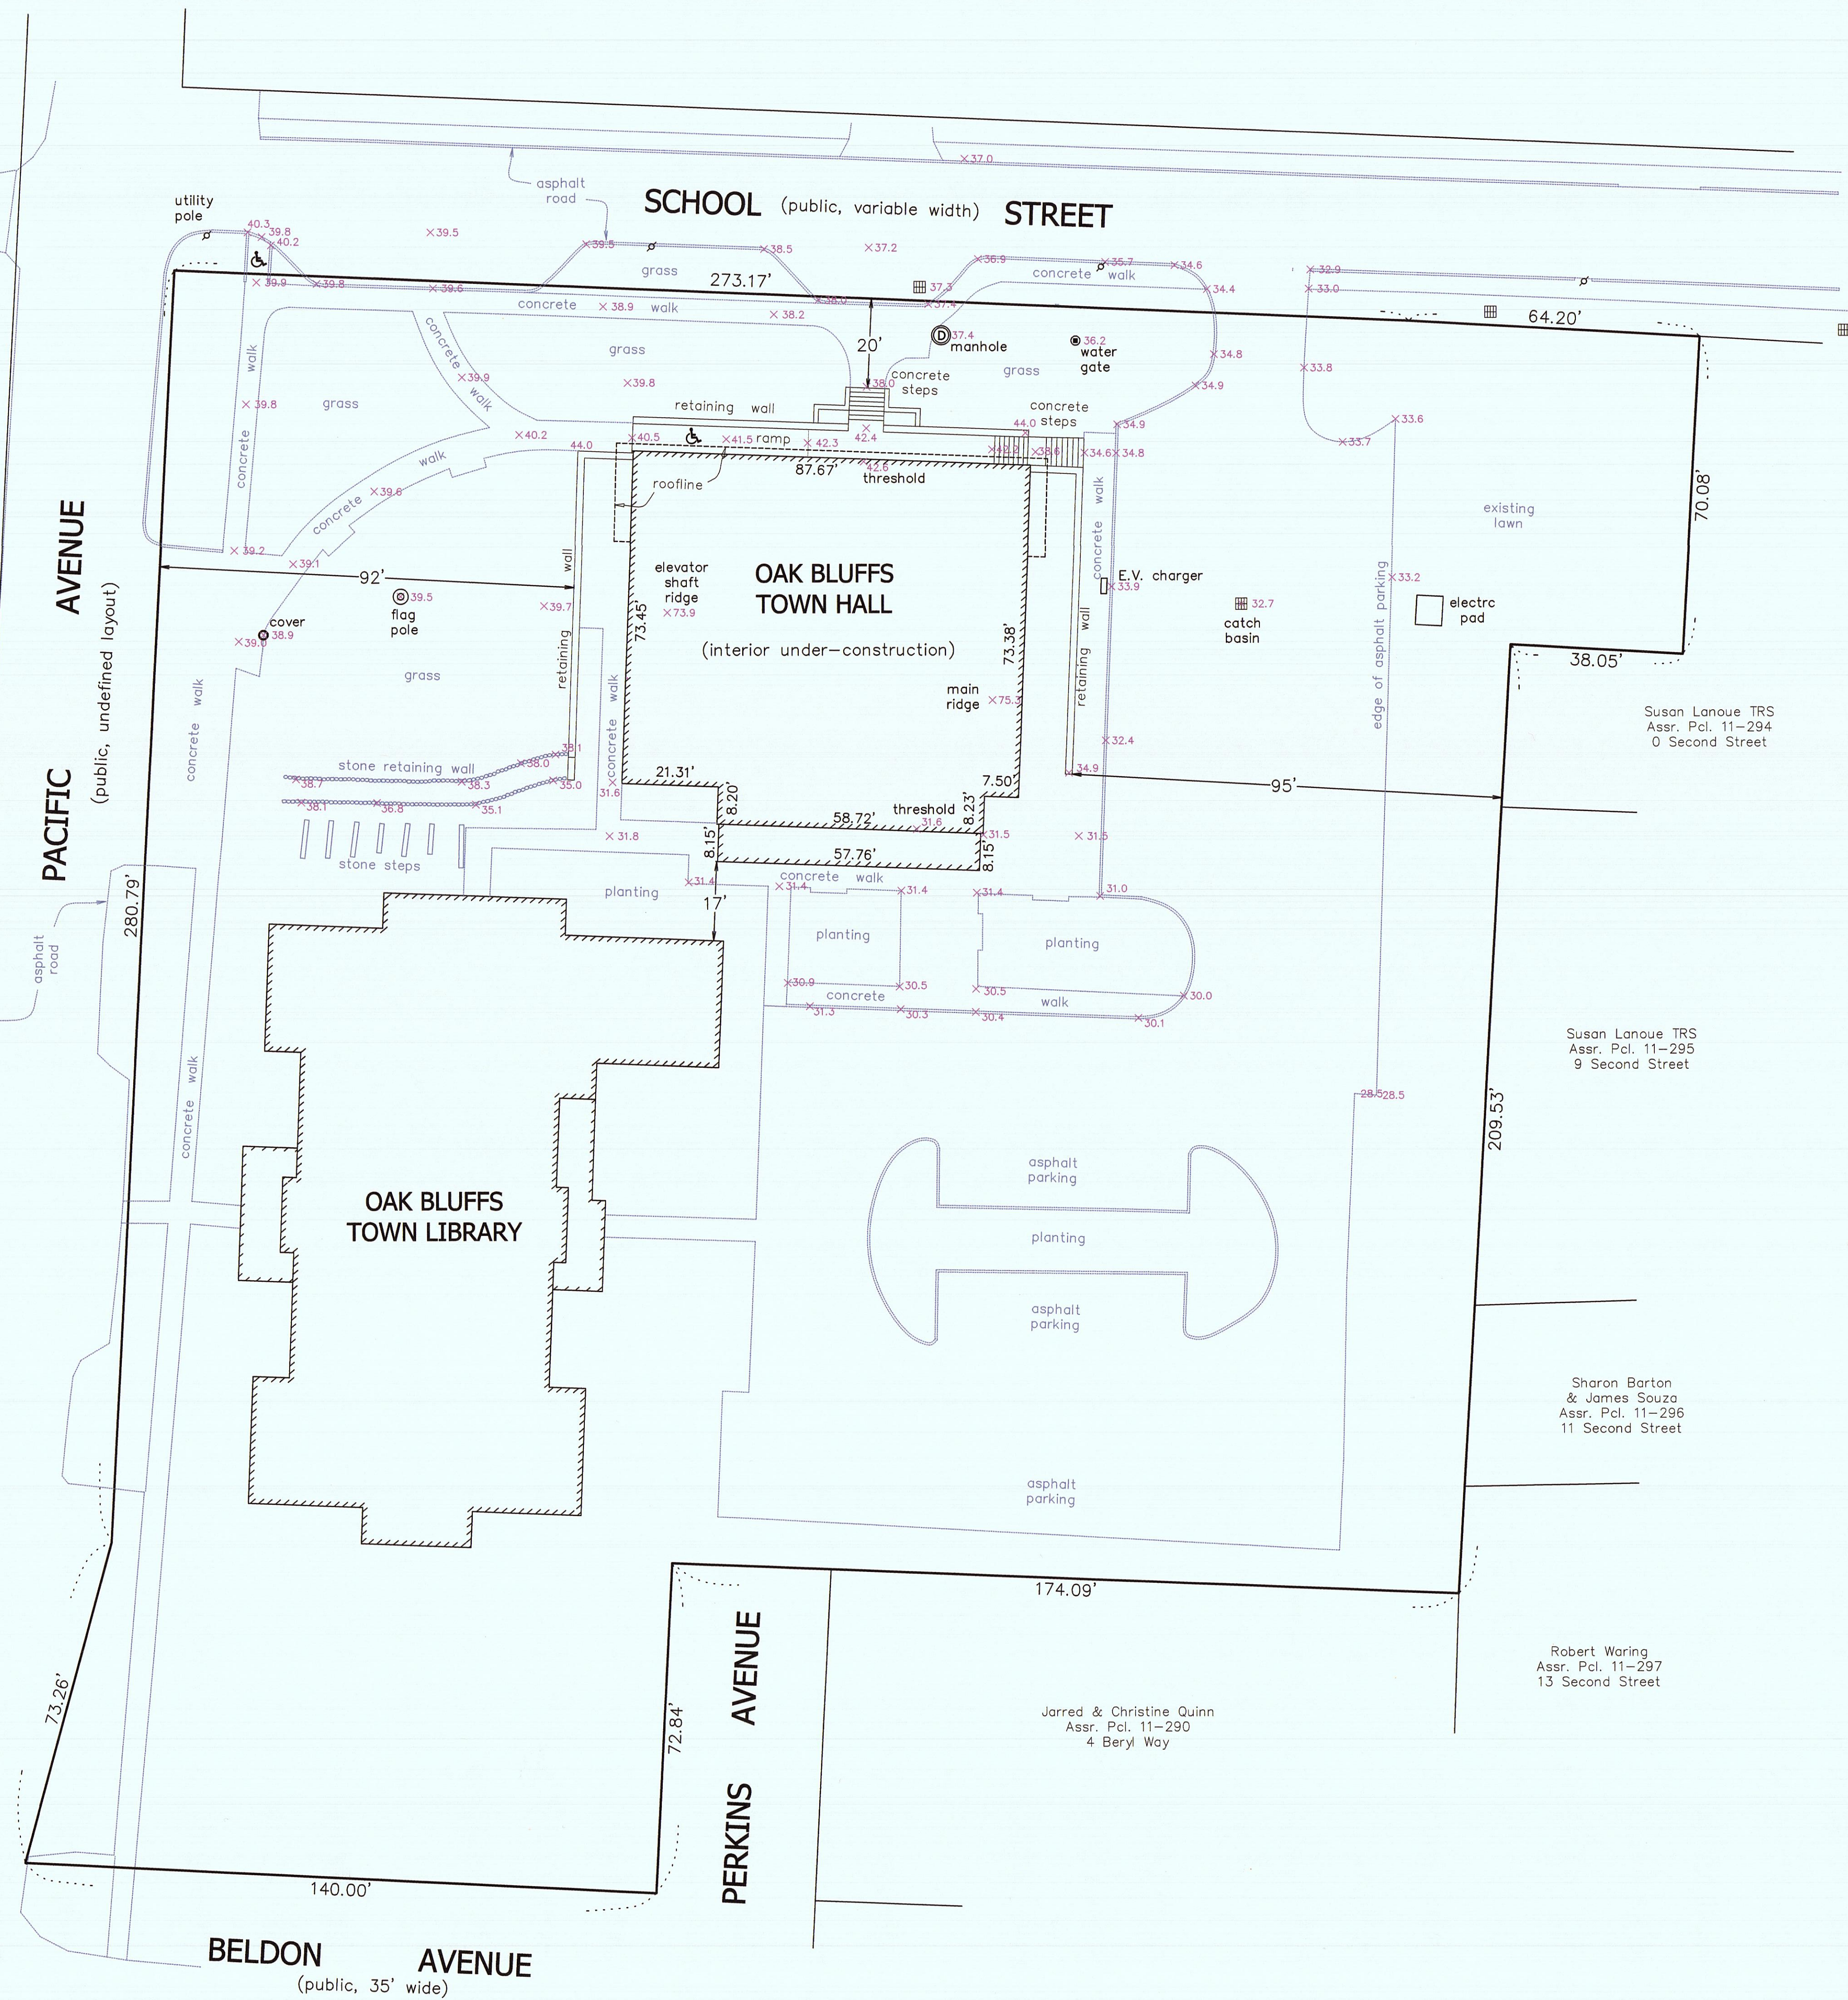

Susan Lanoue TRS  
Assr. Pcl. 11-294  
0 Second Street

Susan Lanoue TRS  
Assr. Pcl. 11-295  
9 Second Street

Sharon Barton  
& James Souza  
Assr. Pcl. 11-296  
11 Second Street

Robert Waring  
Assr. Pcl. 11-297  
13 Second Street

Jarred & Christine Quinn  
Assr. Pcl. 11-290  
4 Beryl Way

### As-Built Town Hall Site Plan Oak Bluffs Assessor Parcel 11-292

56 School Street

Prepared For


The Town of Oak Bluffs

Scale: 1" = 20' December 7, 2021

Revised January 21, 2022  
(as-built elevations)

**Schofield, Barbini & Hoehn Inc.**  
Land Surveying & Civil Engineering

12 Surveyor's Lane, Box 339  
Vineyard Haven, Mass.  
508-693-2781  
www.sbhinc.net  
MV 11252

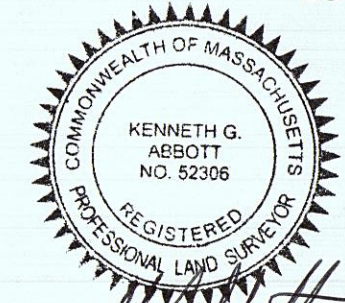

*Kenneth G. Abbott*  
1/21/2022