

No. 3926

FEE \$ 100.00

COMMONWEALTH OF MASSACHUSETTS

Board of Health, TISBURY, MA.

APPLICATION FOR DISPOSAL SYSTEM CONSTRUCTION PERMIT

Application for a Permit to Construct () Repair () Upgrade (x) Abandon () - Complete System Individual Components

Location <u>#286 MAIN STREET</u>	Owner's Name <u>VINEYARD MONTESSORI SCHOOL</u>
Map/Parcel# <u>S-K-19.1</u>	Address <u>6 VINEYARD LAND SURVEYING + ENG INC.</u>
Lot#	Telephone# <u>#12 COURNOYER RD. P.O. BOX 421</u>
Installer's Name	Designer's Name <u>WEST TISBURY MA 02575</u>
Address	Address
Telephone#	Telephone# <u>508-693-3774</u>

VLS+E #1819

Type of Building COMMERCIAL Lot Size 18,022 sq. ft.
 Dwelling - No. of Bedrooms _____ Garbage grinder ()
 Other - Type of Building _____ No. of persons _____ Showers (), Cafeteria ()
 Other Fixtures _____
 Design Flow (min. required) _____ gpd Calculated design flow _____ Design flow provided _____ gpd
 Plan: Date MARCH 29, 2015 Number of sheets _____ Revision Date _____
 Title PROPOSED SEPTIC TIE-IN SKETCH
 Description of Soil(s) _____
 Soil Evaluator Form No. _____ Name of Soil Evaluator _____ Date of Evaluation _____

DESCRIPTION OF REPAIRS OR ALTERATIONS TO CONVERT AN EXISTING CESSPOOL INTO A SEPTIC TANK AND TIE IT INTO THE EXISTING OVERFLOW CESSPOOL. ADD RISERS TO OVERFLOW CESSPOOL #1

The undersigned agrees to install the above described Individual Sewage Disposal System in accordance with the provisions of TITLE 5 and further agrees to not to place the system in operation until a Certificate of Compliance has been issued by the Board of Health.

Signed [Signature] Date 6/3/2015

Inspections _____

APPLICATION APPROVED BY:

No. 3926

FEE \$ 100.00

COMMONWEALTH OF MASSACHUSETTS

Board of Health, TISBURY, MA.

CERTIFICATE OF COMPLIANCE

Description of Work: Individual Component(s) Complete System
 The undersigned hereby certify that the Sewage Disposal System; Constructed (), Repaired (), Upgraded (x), Abandoned ()
 by: VINEYARD MONTESSORI SCHOOL
 at #286 MAIN STREET (ASSR-PCL S-K-19.1)
 has been installed in accordance with the provisions of 310 CMR 15.00 (Title 5) and the approved design plans/as-built plans relating to
 application No. 3926, dated 6/9/15. Approved Design Flow _____ (gpd)
 Installer Vineyard Engineering
 Designer: VLS+E INC. Inspector: [Signature] Date: 8/8/2015
 The issuance of this permit shall not be construed as a guarantee that the system will function as designed.

VLS+E #1819

No. 3926

FEE \$ 100.00

COMMONWEALTH OF MASSACHUSETTS

Board of Health, TISBURY, MA.

DISPOSAL SYSTEM CONSTRUCTION PERMIT

Permission is hereby granted to; Construct () Repair () Upgrade (x) Abandon () an individual sewage disposal system
 at #286 MAIN STREET (ASSR-PCL S-K-19.1) as described in the application for
 Disposal System Construction Permit No. 3926, dated 6/9/15.

Provided: Construction shall be completed within three years of the date of this permit. All local conditions must be met.

Date 6/9/15 Board of Health [Signature]




VLS+E #1819

DATE 6/9/15

NEPOBAI WORKS PLAN APPROVED BY:

Assr-Pcl 5-K-19.2

- NOTE:
1. Convert cesspool to be equipped with a gas baffle.
 2. Invert at cesspool to have minimum pitch of 1% to the existing sewerline to the overflow cesspool #2.

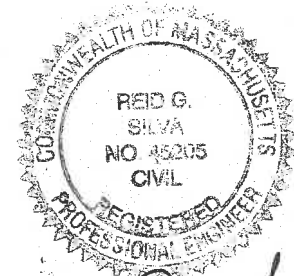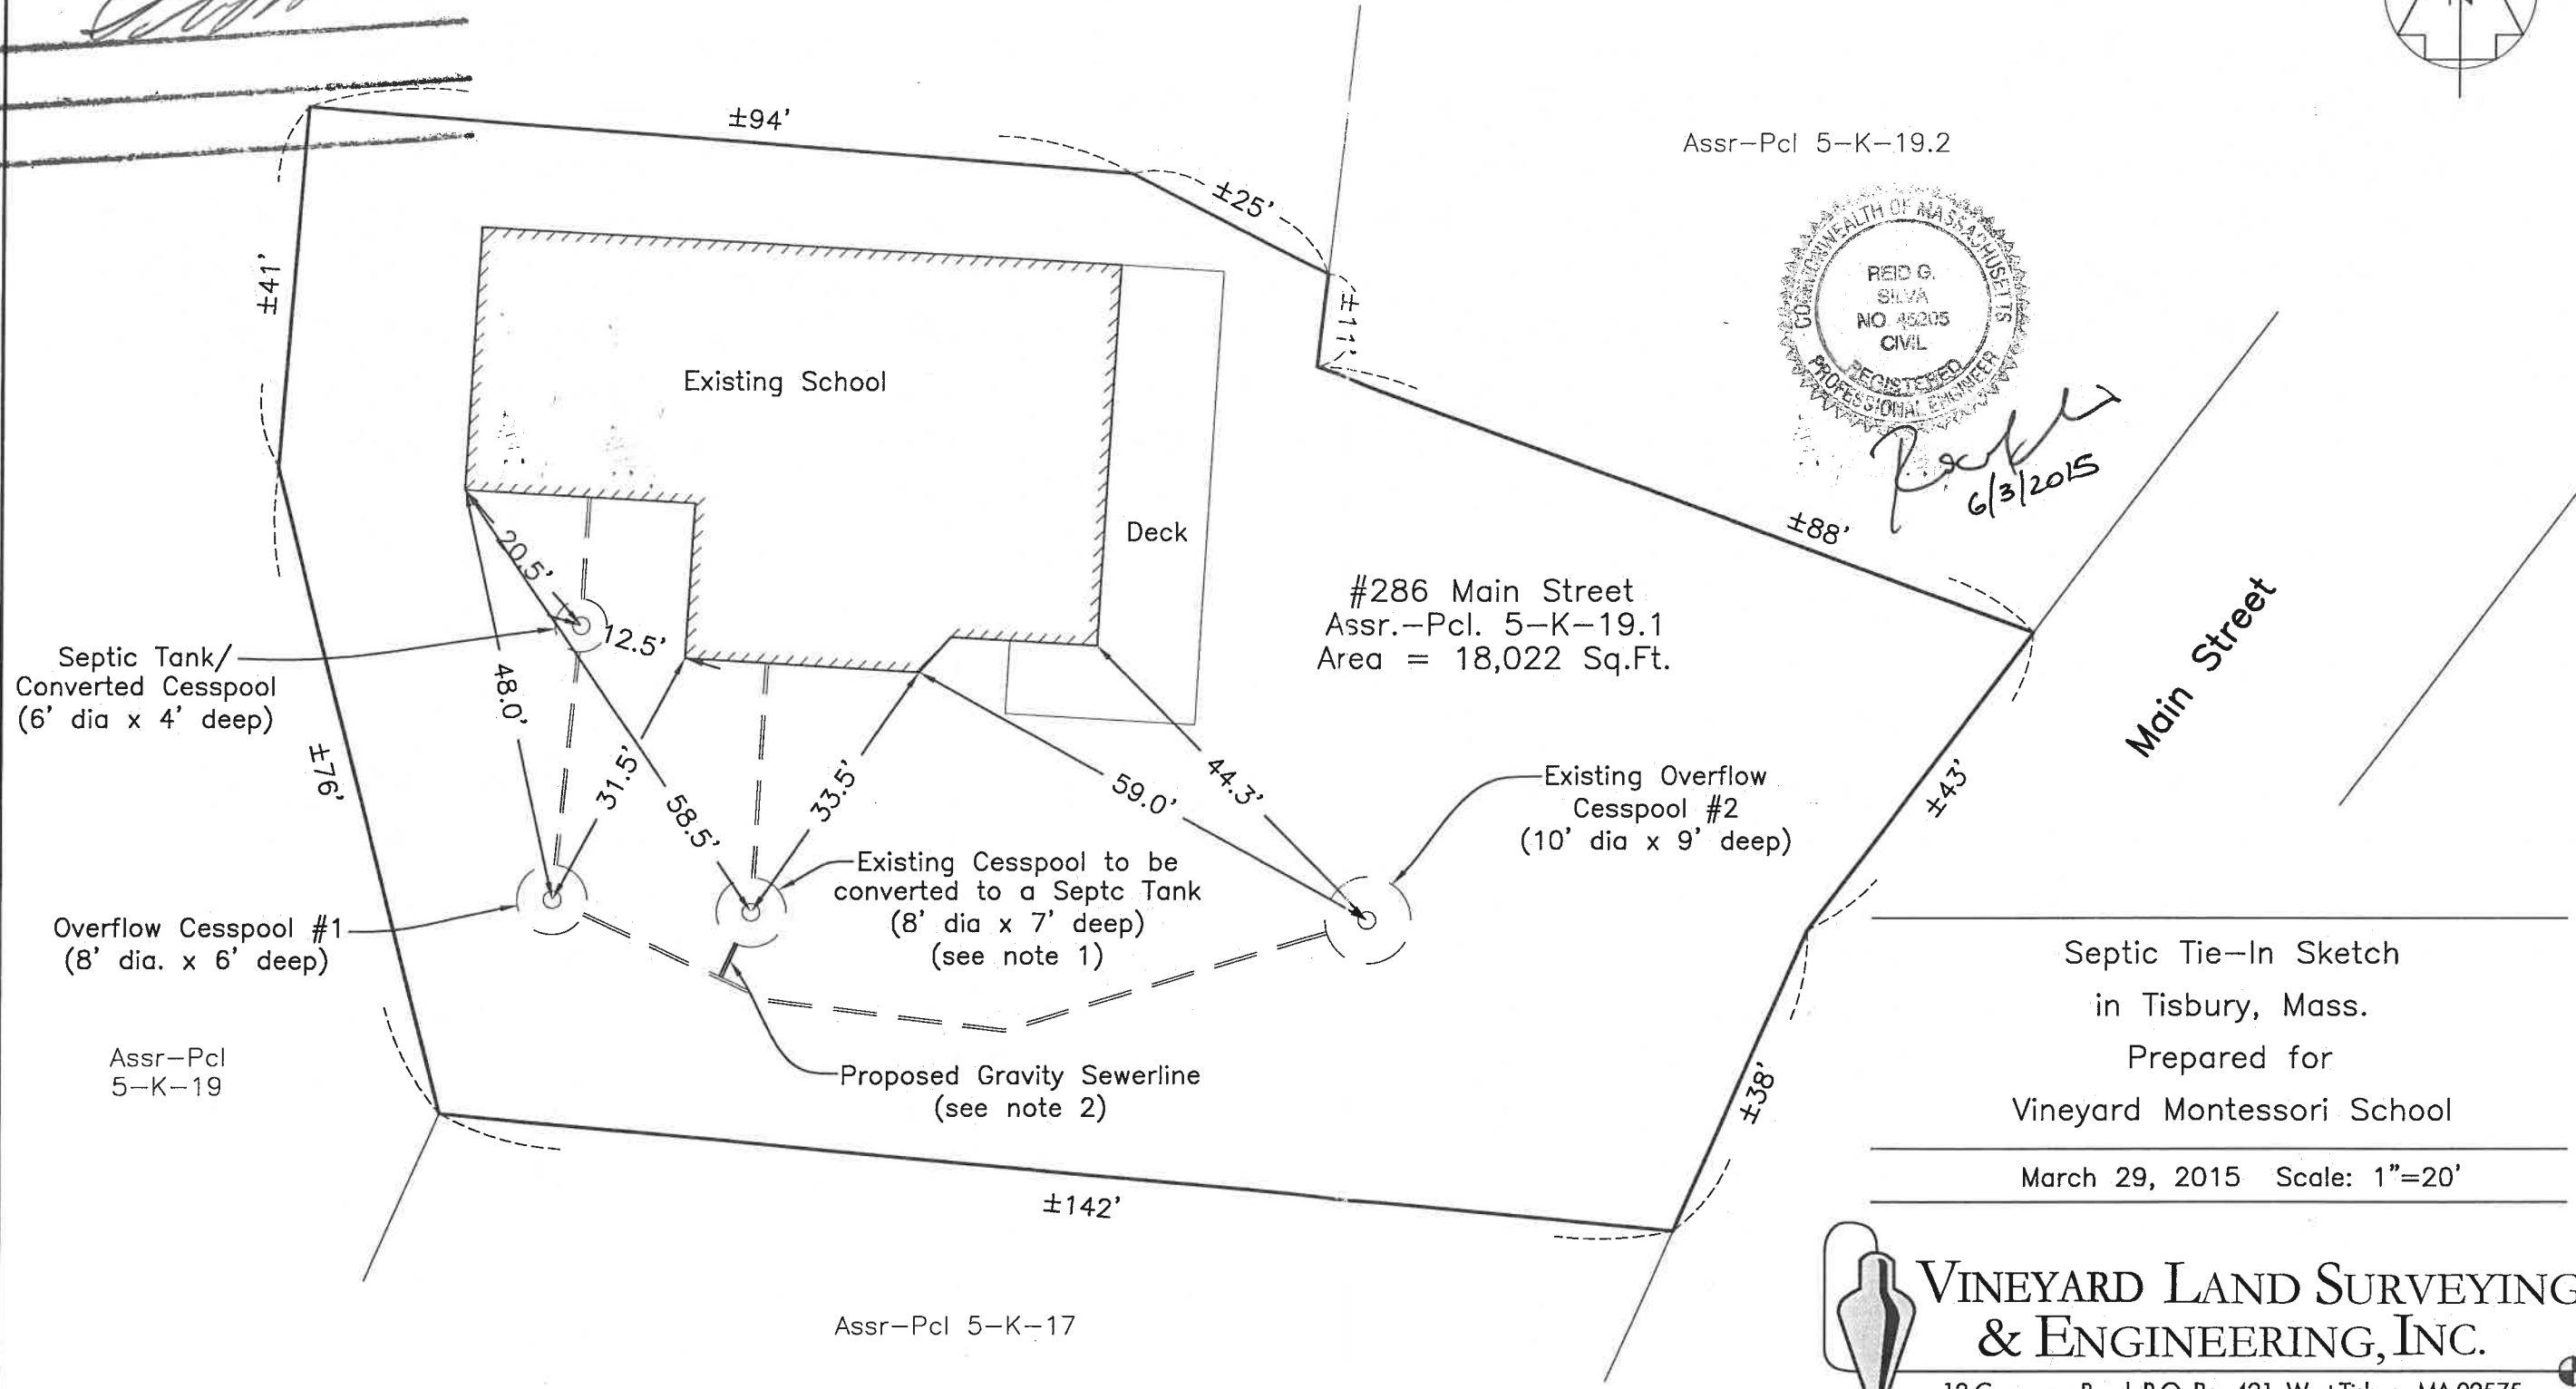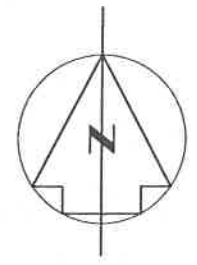

Reid G. Silva
6/3/2015

#286 Main Street
Assr.-Pcl. 5-K-19.1
Area = 18,022 Sq.Ft.

Septic Tie-In Sketch
in Tisbury, Mass.
Prepared for
Vineyard Montessori School
March 29, 2015 Scale: 1"=20'

VINEYARD LAND SURVEYING & ENGINEERING, INC.
12 Courmoyer Road, P.O. Box 421 West Tisbury, MA 02575
P 508.693.3774 F 508.693.8575